
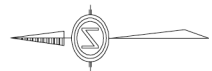


**FULL FRAME**

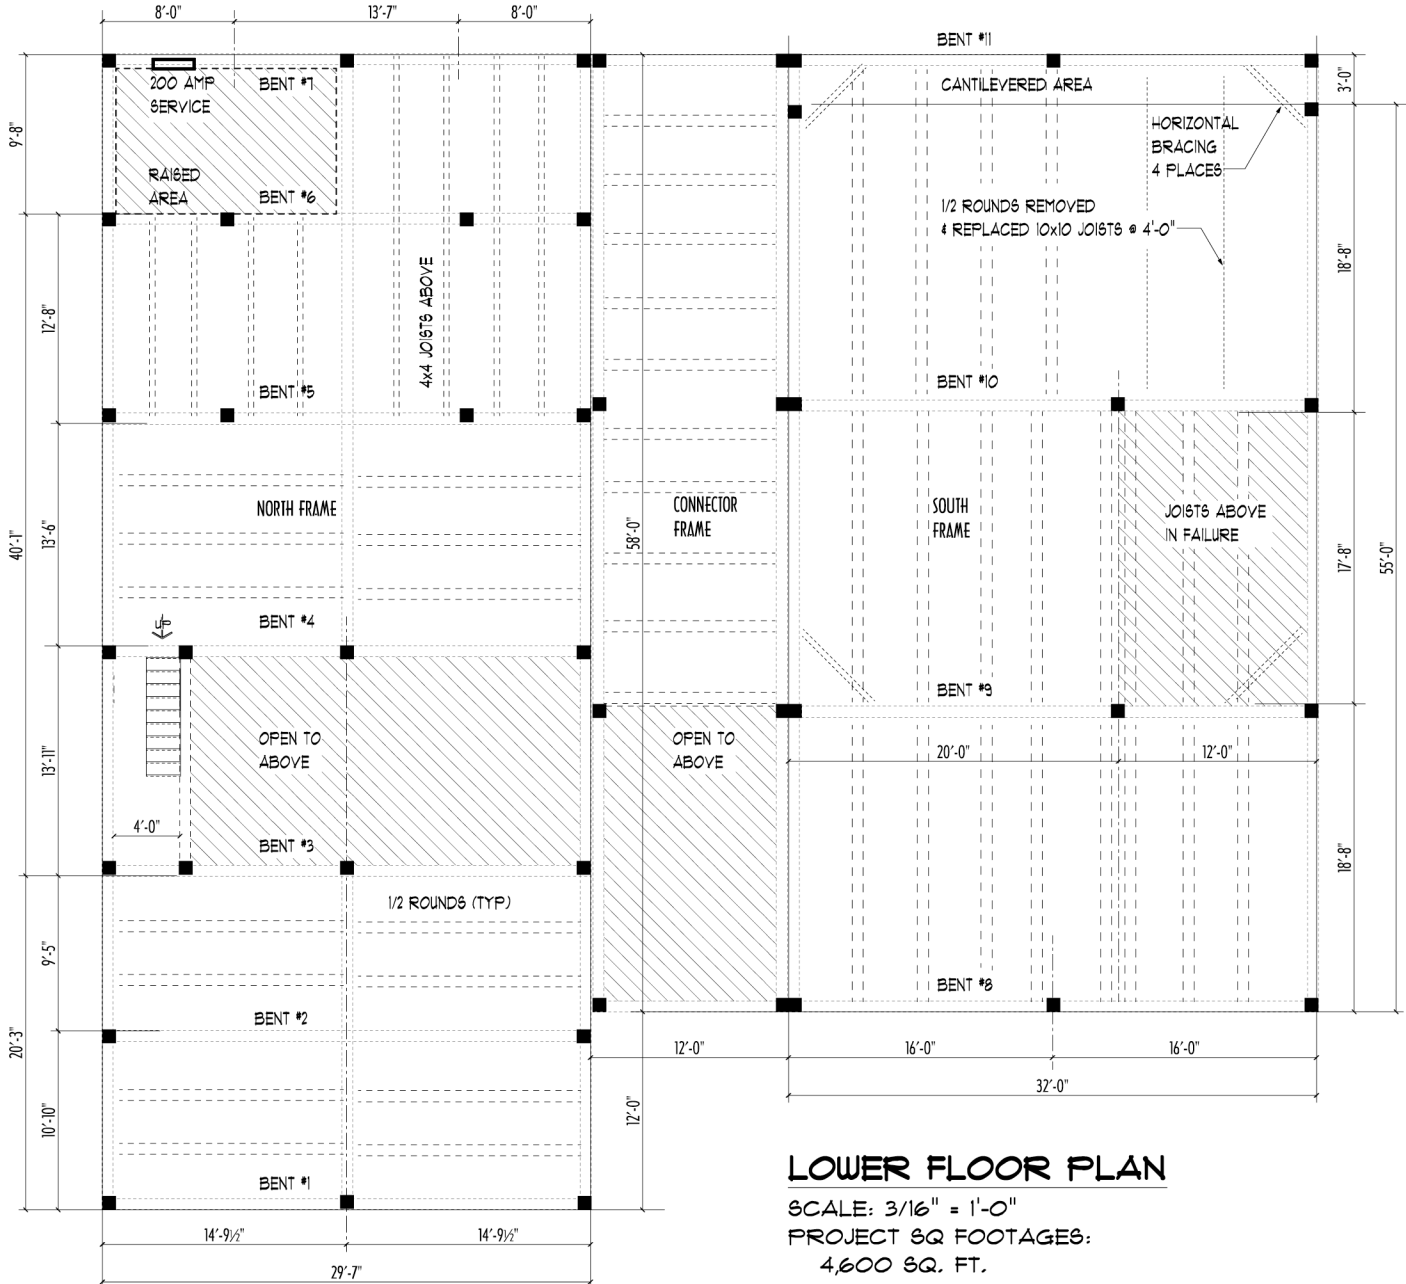

**LOWER FLOOR PLAN**

SCALE: 3/16" = 1'-0"  
PROJECT SQ FOOTAGES:  
4,600 SQ. FT.

**McNAMARA CONSTRUCTION**  
TRADITIONAL TIMBER FRAMING & SUSTAINABLE CONSTRUCTION  
RR #1 BOX 1368, FRIENDSVILLE, PA 18818 Phone: 510-553-2432 Fax: 510-553-2432

**DEMARO FRAME**  
**AS-BUILTS**

**AS-2**  
May 08, 2012