



BENTS #1 & #3

SCALE: 3/16" = 1'-0"

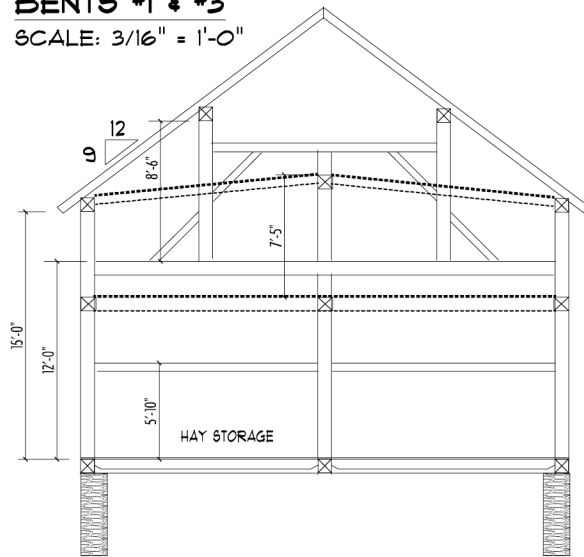


BENT #2

SCALE: 3/16" = 1'-0"

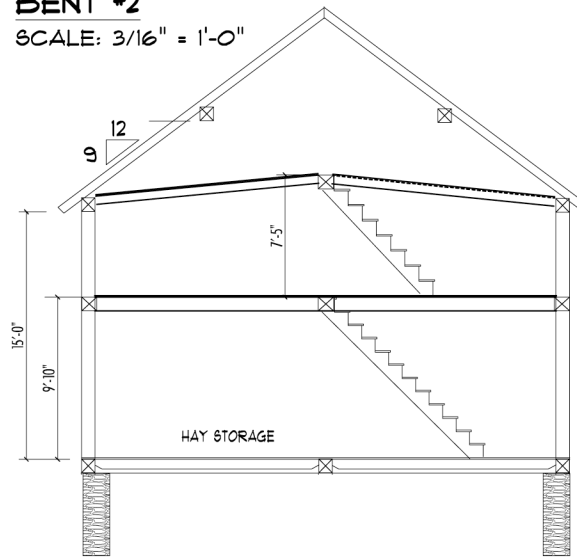


BENTS #7 & #4

SCALE: 3/16" = 1'-0"

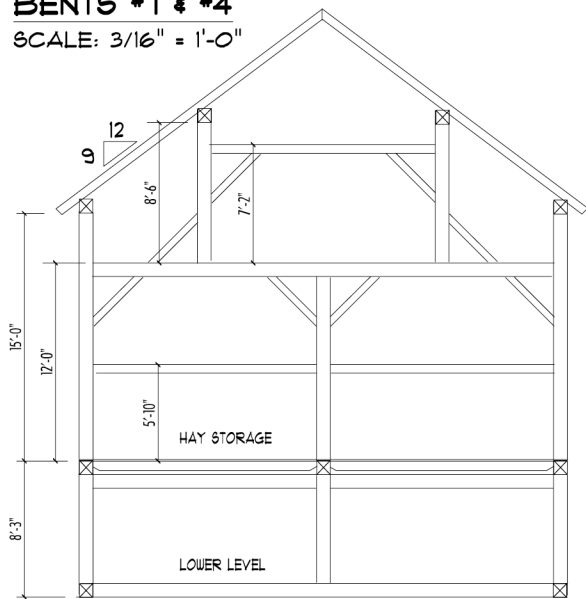

BENTS #5 & #6

SCALE: 3/16" = 1'-0"

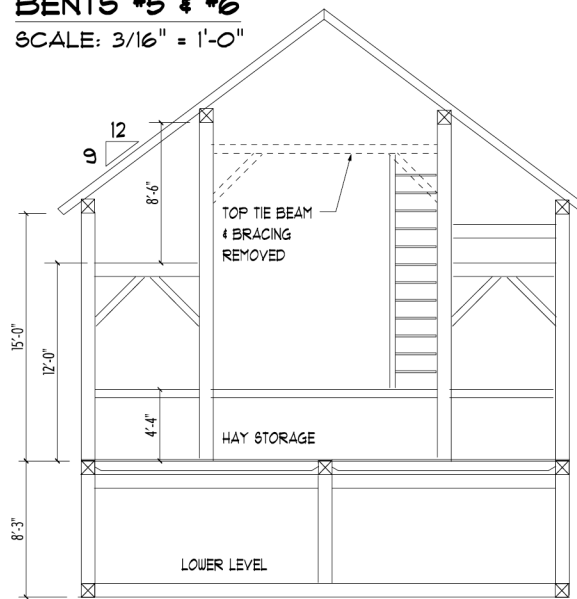

McNAMARA CONSTRUCTION

TRADITIONAL TIMBER FRAMING & SUSTAINABLE CONSTRUCTION

RR#1 BOX 1368, FRIENDSVILLE, PA 18818 Phone: 510-553-2432 Fax: 510-553-2432

DEMARO FRAME

AS-BUILTS

AS-3

May 08, 2012