



AS-BUILTS

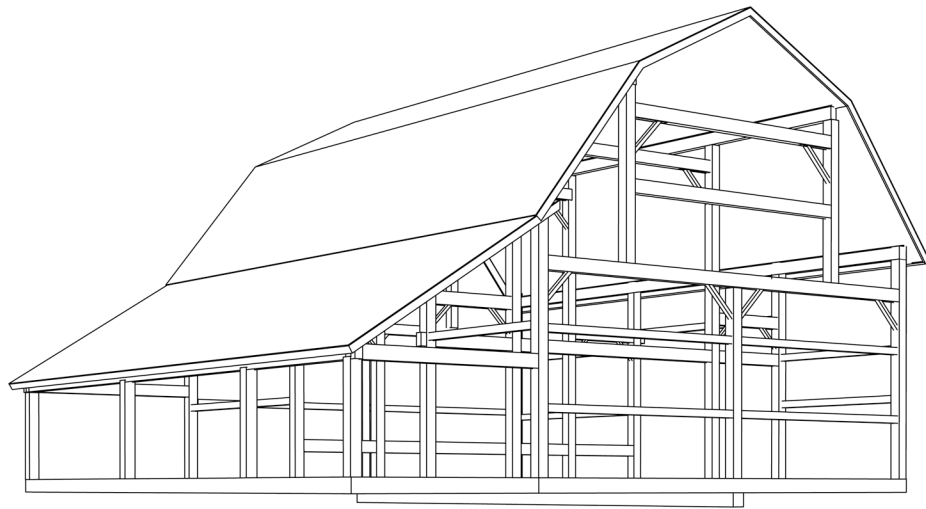


EYE WALL G-G

SCALE: 1/4" = 1'-0"

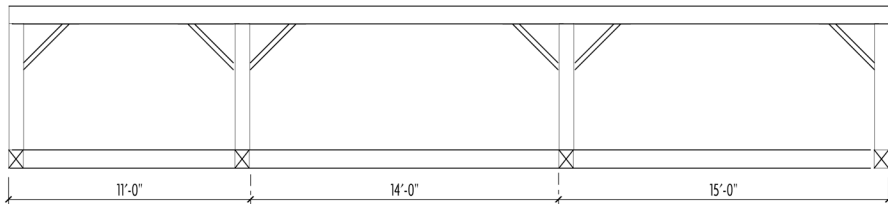


CENTER BENT B-B

SCALE: 1/4" = 1'-0"

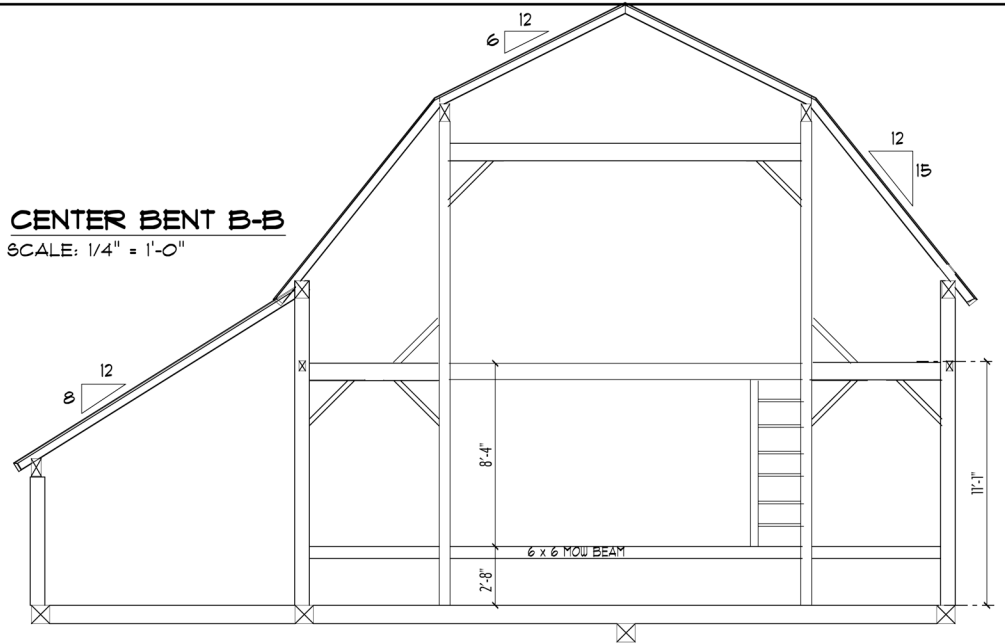

SOUTH BENT D-D

SCALE: 1/4" = 1'-0"

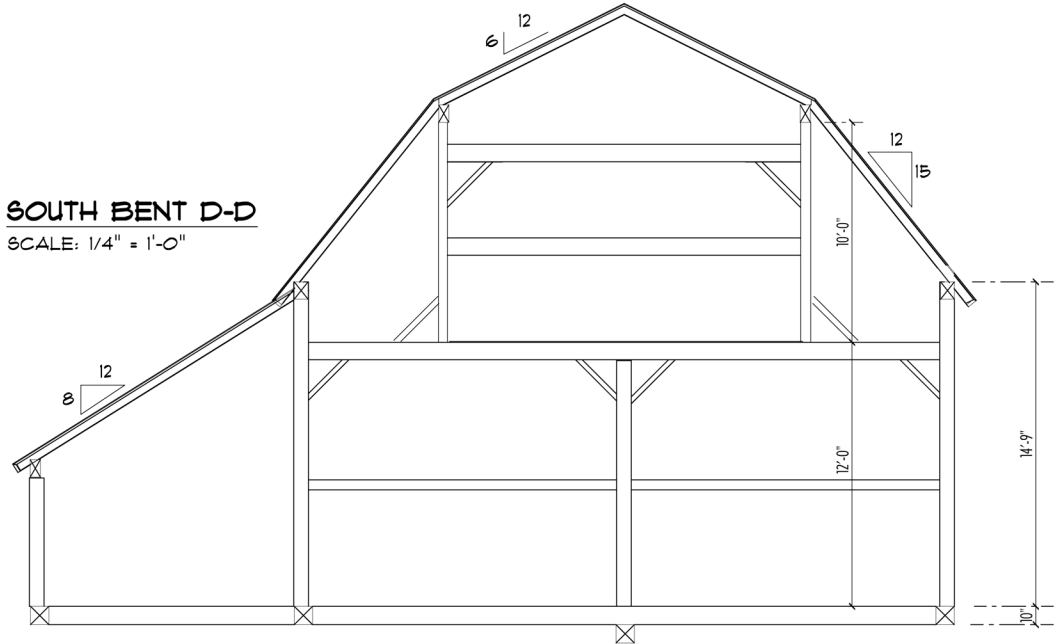

McNAMARA CONSTRUCTION

TRADITIONAL TIMBER FRAMING & SUSTAINABLE CONSTRUCTION

RR#1 BOX 1368, FRIENDSVILLE, PA 18818 Phone: 570-553-2432 Fax: 570-553-2432

OWEGO NEW MILFORD TRPK FRAME
FOREST LAKE, PA

AS-3

June 02, 2011