


HORSE BARN AS-BUILTS


EYE WALL

SCALE: 3/16" = 1'-0"

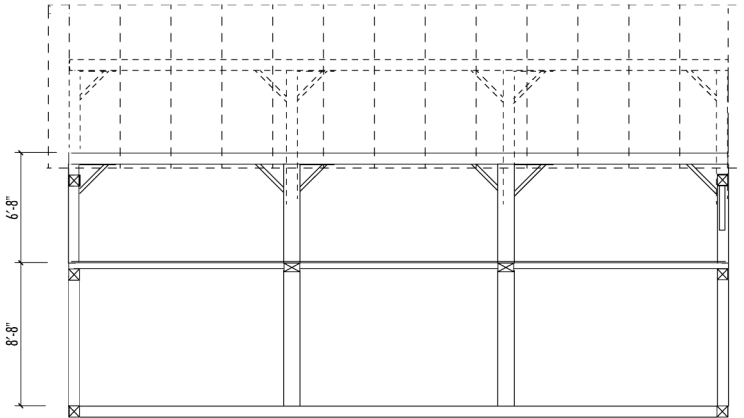


WEST BENT #1

SCALE: 3/16" = 1'-0"

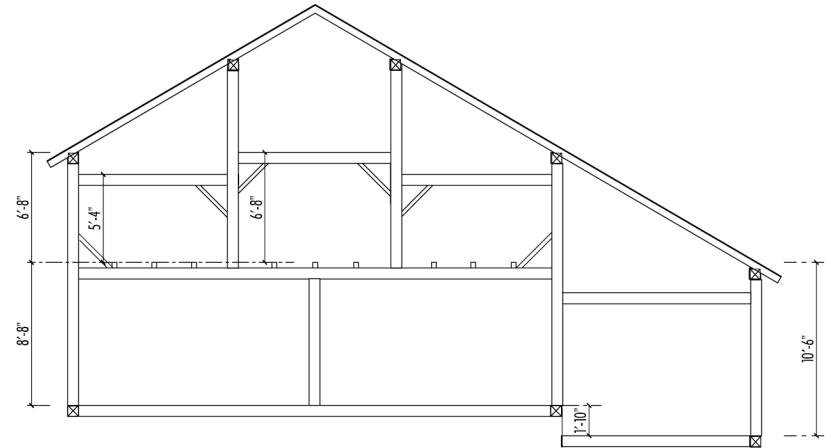


EAST BENT #4

SCALE: 3/16" = 1'-0"

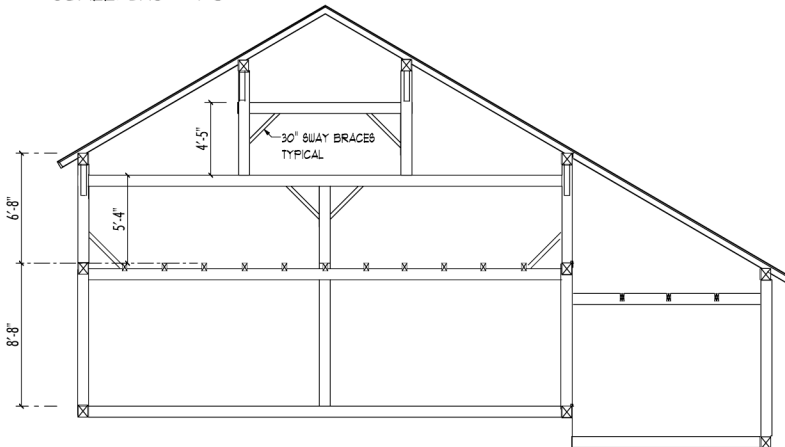

CENTER BENTS #2 & #3

SCALE: 3/16" = 1'-0"

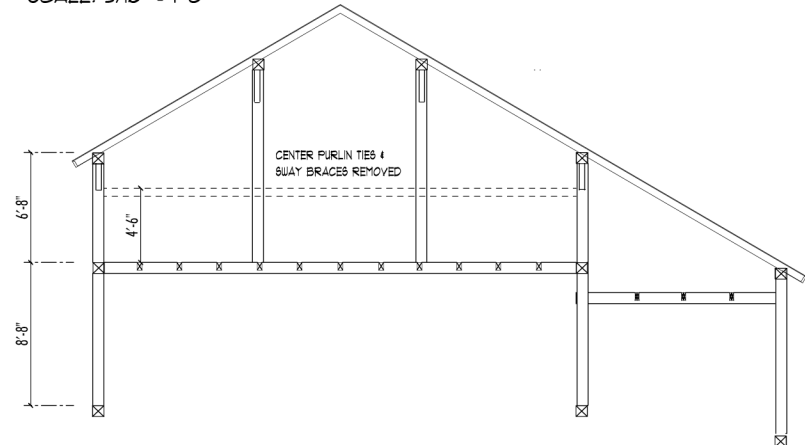

McNAMARA CONSTRUCTION

TRADITIONAL TIMBER FRAMING & SUSTAINABLE CONSTRUCTION
RR#1 BOX 1368, FRIENDSVILLE, PA 18818 Phone: 570-553-2432 Fax: 570-553-2432

WALZ PROJECT
OWEGO TWP, FOREST LAKE, PA

AS-2

December 08, 2011