


HOUSE AS-BUILTS


UPPER FLOOR PLAN

SCALE: 3/16" = 1'-0"
PROJECT SQ FOOTAGES:
952 SQ. FT.

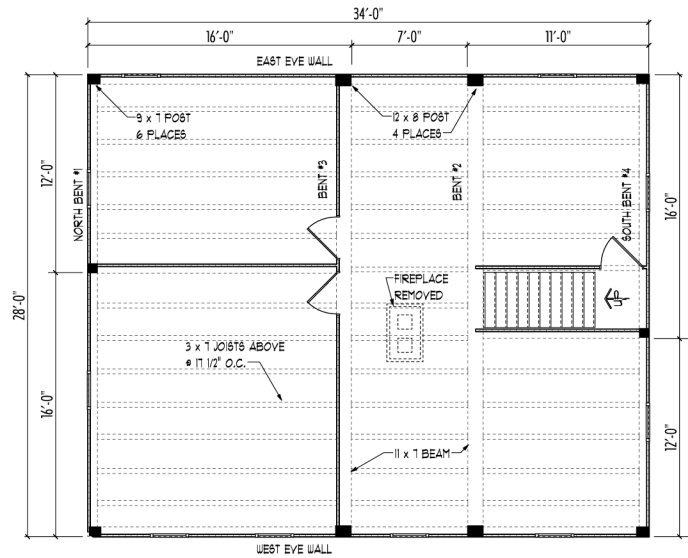


MAIN FLOOR PLAN

SCALE: 3/16" = 1'-0"
PROJECT SQ FOOTAGES:
952 SQ. FT.

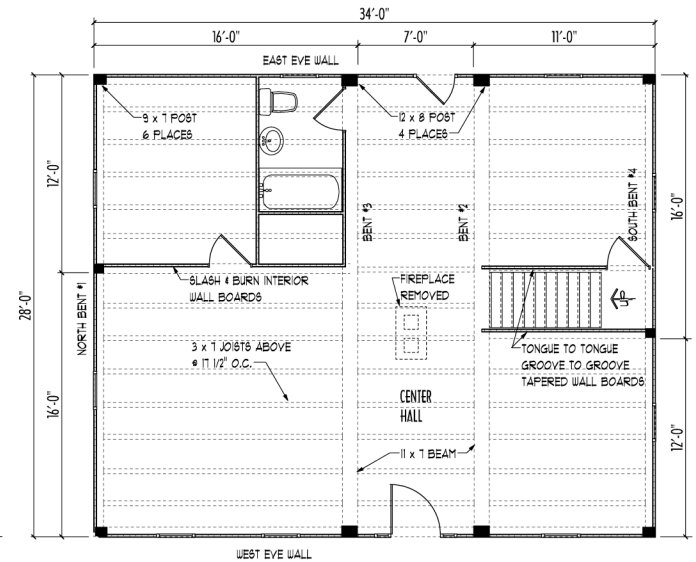

LOWER FLOOR PLAN

SCALE: 3/16" = 1'-0"
PROJECT SQ FOOTAGES:
952 SQ. FT.

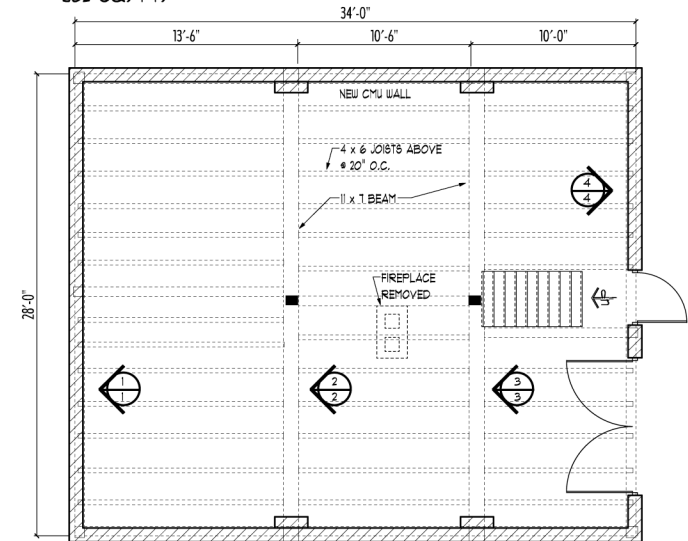

McNAMARA CONSTRUCTION

TRADITIONAL TIMBER FRAMING & SUSTAINABLE CONSTRUCTION
RR#1 BOX 1368, FRIENDSVILLE, PA 18818 Phone: 570-553-2432 Fax: 570-553-2432

WALZ PROJECT
OWEGO TWP, FOREST LAKE, PA

AS-1

December 04, 2011