



**EAST EYE WALL**  
SCALE: 3/16" = 1'-0"

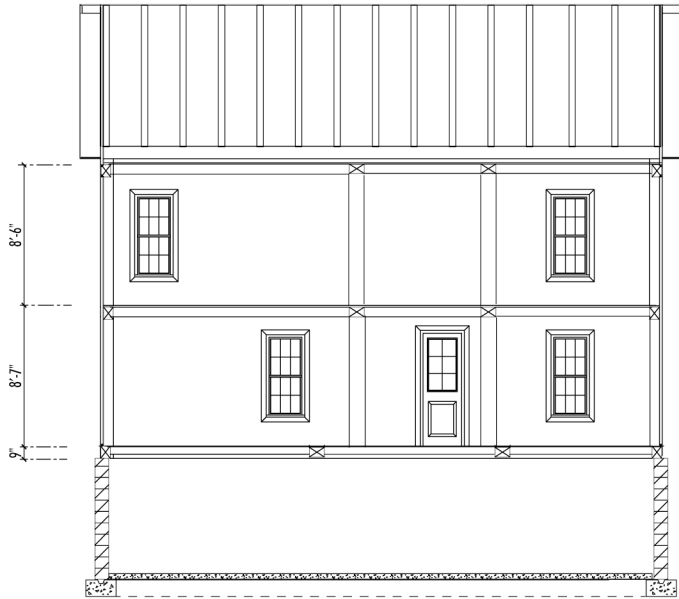


**WEST EYE WALL**  
SCALE: 3/16" = 1'-0"

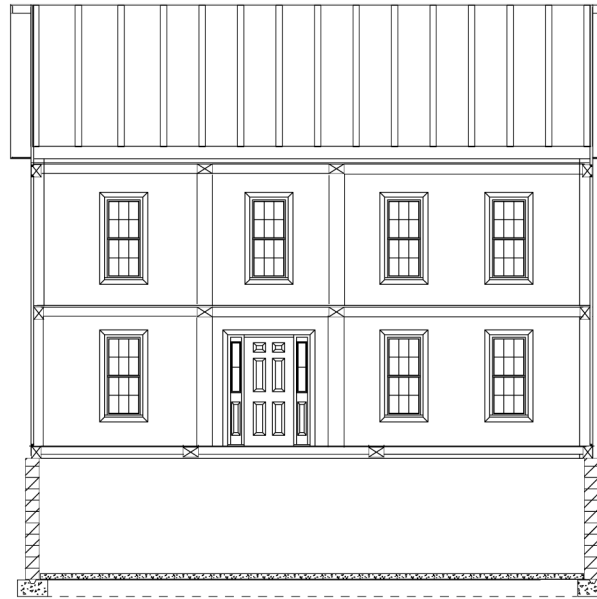


**HOUSE AS-BUILTS**


**EYE WALL DETAIL**  
NOT TO SCALE

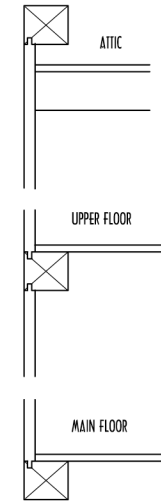


**GABLE WALL DETAIL**  
NOT TO SCALE

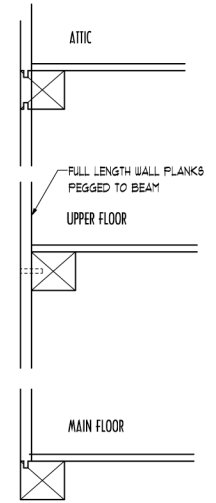


**GABLE BENT #1**  
SCALE: 3/16" = 1'-0"

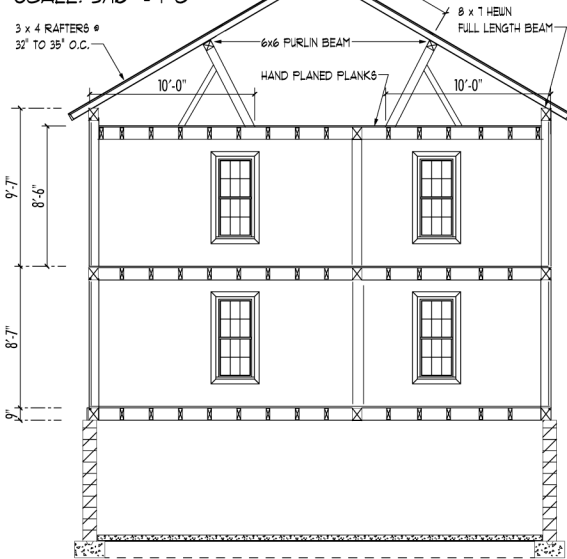

**GABLE BENTS #4**  
SCALE: 3/16" = 1'-0"

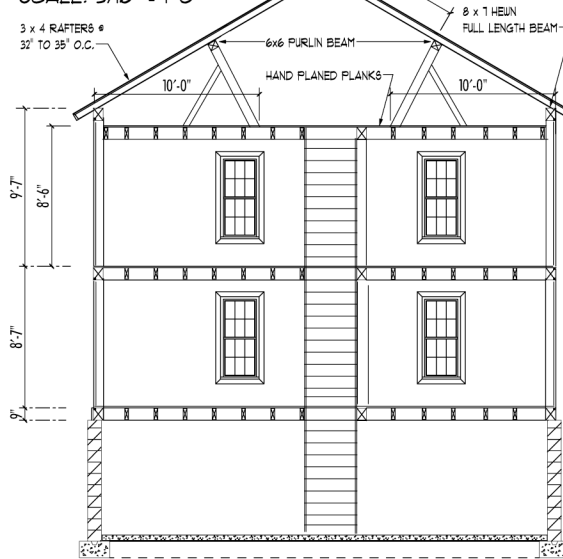

**CENTER BENTS #2 & #3**  
SCALE: 3/16" = 1'-0"

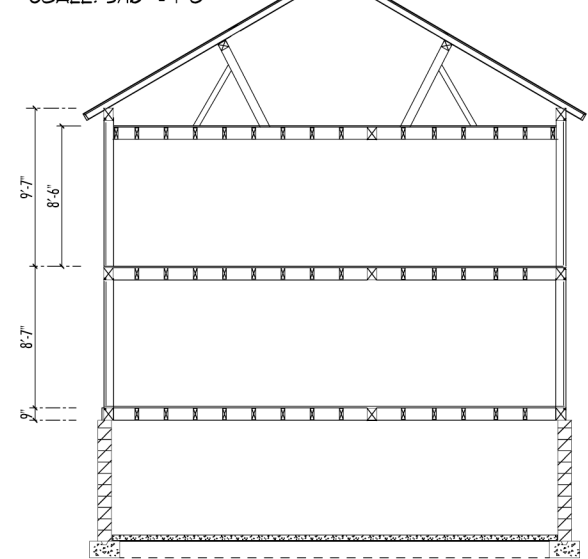

**McNAMARA CONSTRUCTION**

TRADITIONAL TIMBER FRAMING & SUSTAINABLE CONSTRUCTION  
RR#1 BOX 1368, FRIENDSVILLE, PA 18818 Phone: 510-553-2432 Fax: 510-553-2432

**WALZ PROJECT**  
**OWEGO TWP, FOREST LAKE, PA**

**AS-2**

December 04, 2011