



**EYE WALL**

SCALE: 1/4" = 1'-0"

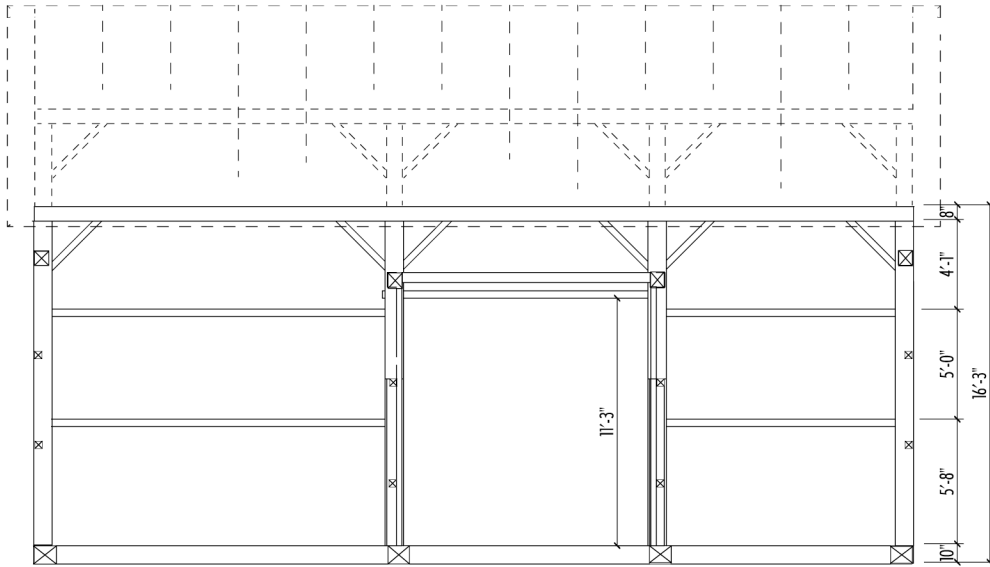


**THRESHING BARN AS-BUILTS**

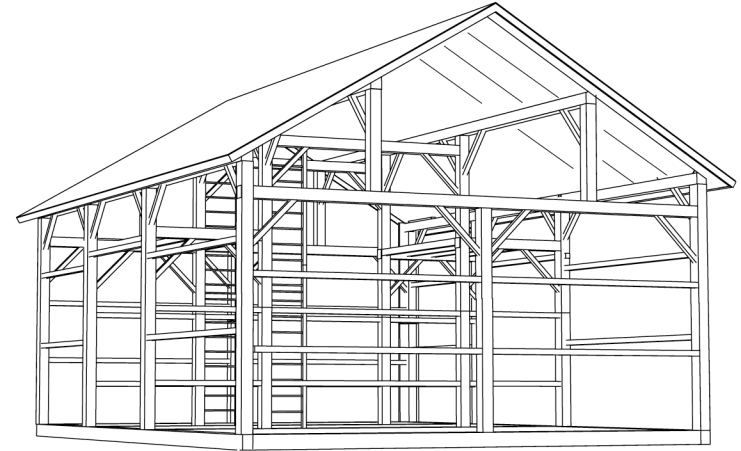


**EAST BENT #4**

SCALE: 1/4" = 1'-0"

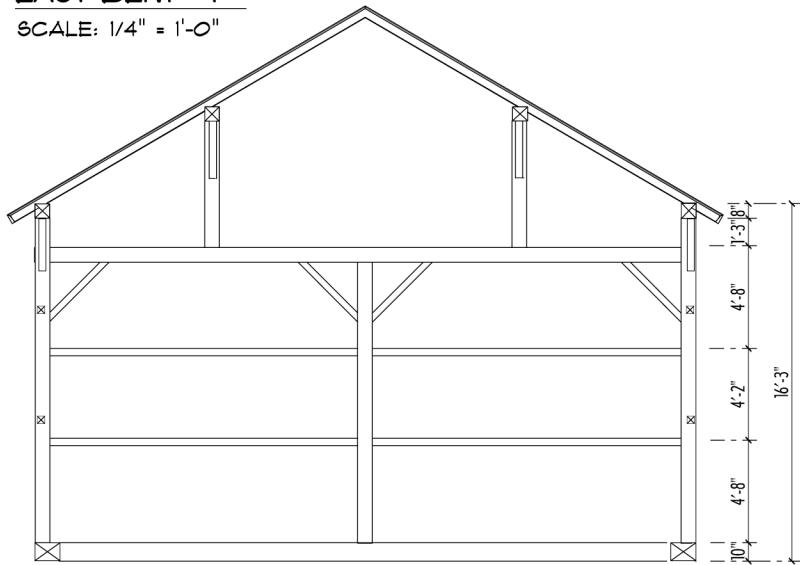

**CENTER BENTS #2 & #3**

SCALE: 1/4" = 1'-0"

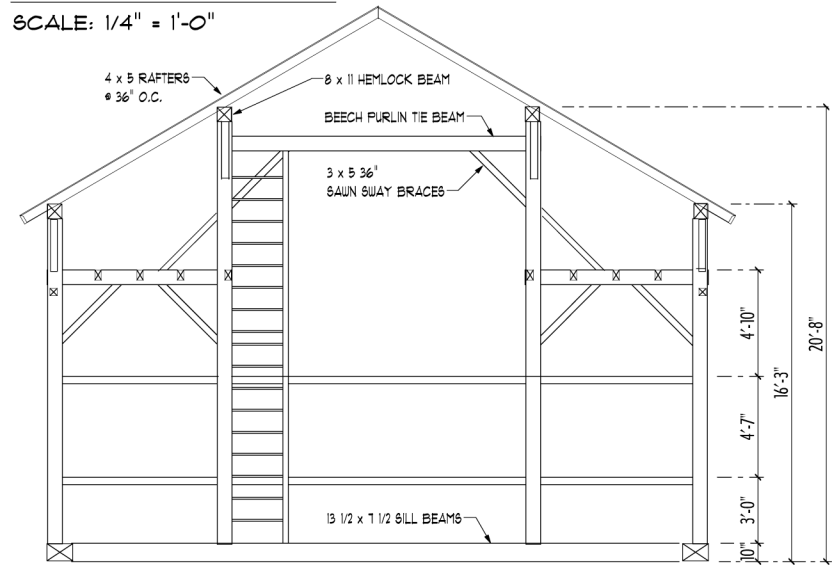

**McNAMARA CONSTRUCTION**

TRADITIONAL TIMBER FRAMING & SUSTAINABLE CONSTRUCTION

RR#1 BOX 1368, FRIENDSVILLE, PA 18818 Phone: 570-553-2432 Fax: 570-553-2432

**WALZ PROJECT**  
**OWEGO TWP, FOREST LAKE, PA**

**AS-1**

December 08, 2011